





Development Information	
Development Name: ASTON HILLS	Developer Company: LANSER DEVELOPMENTS
Development Address: MOUNT BARKER	
Authorised Rep: ADRIAN CADZOW Phone: 08 8406 1300 E-Mail: acadzow@greenhillaustralia.com.au	
CRM ID: AYCA-34VBR1	Stage Number: 7

BILL OF MATERIAL				
NO OF LOTS: 19				
PITS		DUCTS		
SIZE	QTY	SIZE	QTY	MTRS
2	0	P100	11	398.8
5	8	P50	0	0
8	0	P23	21	367.4
9	0			
TOTAL NUMBER OF PITS: 8				
TOTAL NUMBER OF CONDUITS: 32				
TOTAL LENGTH OF CONDUITS: 766.2				

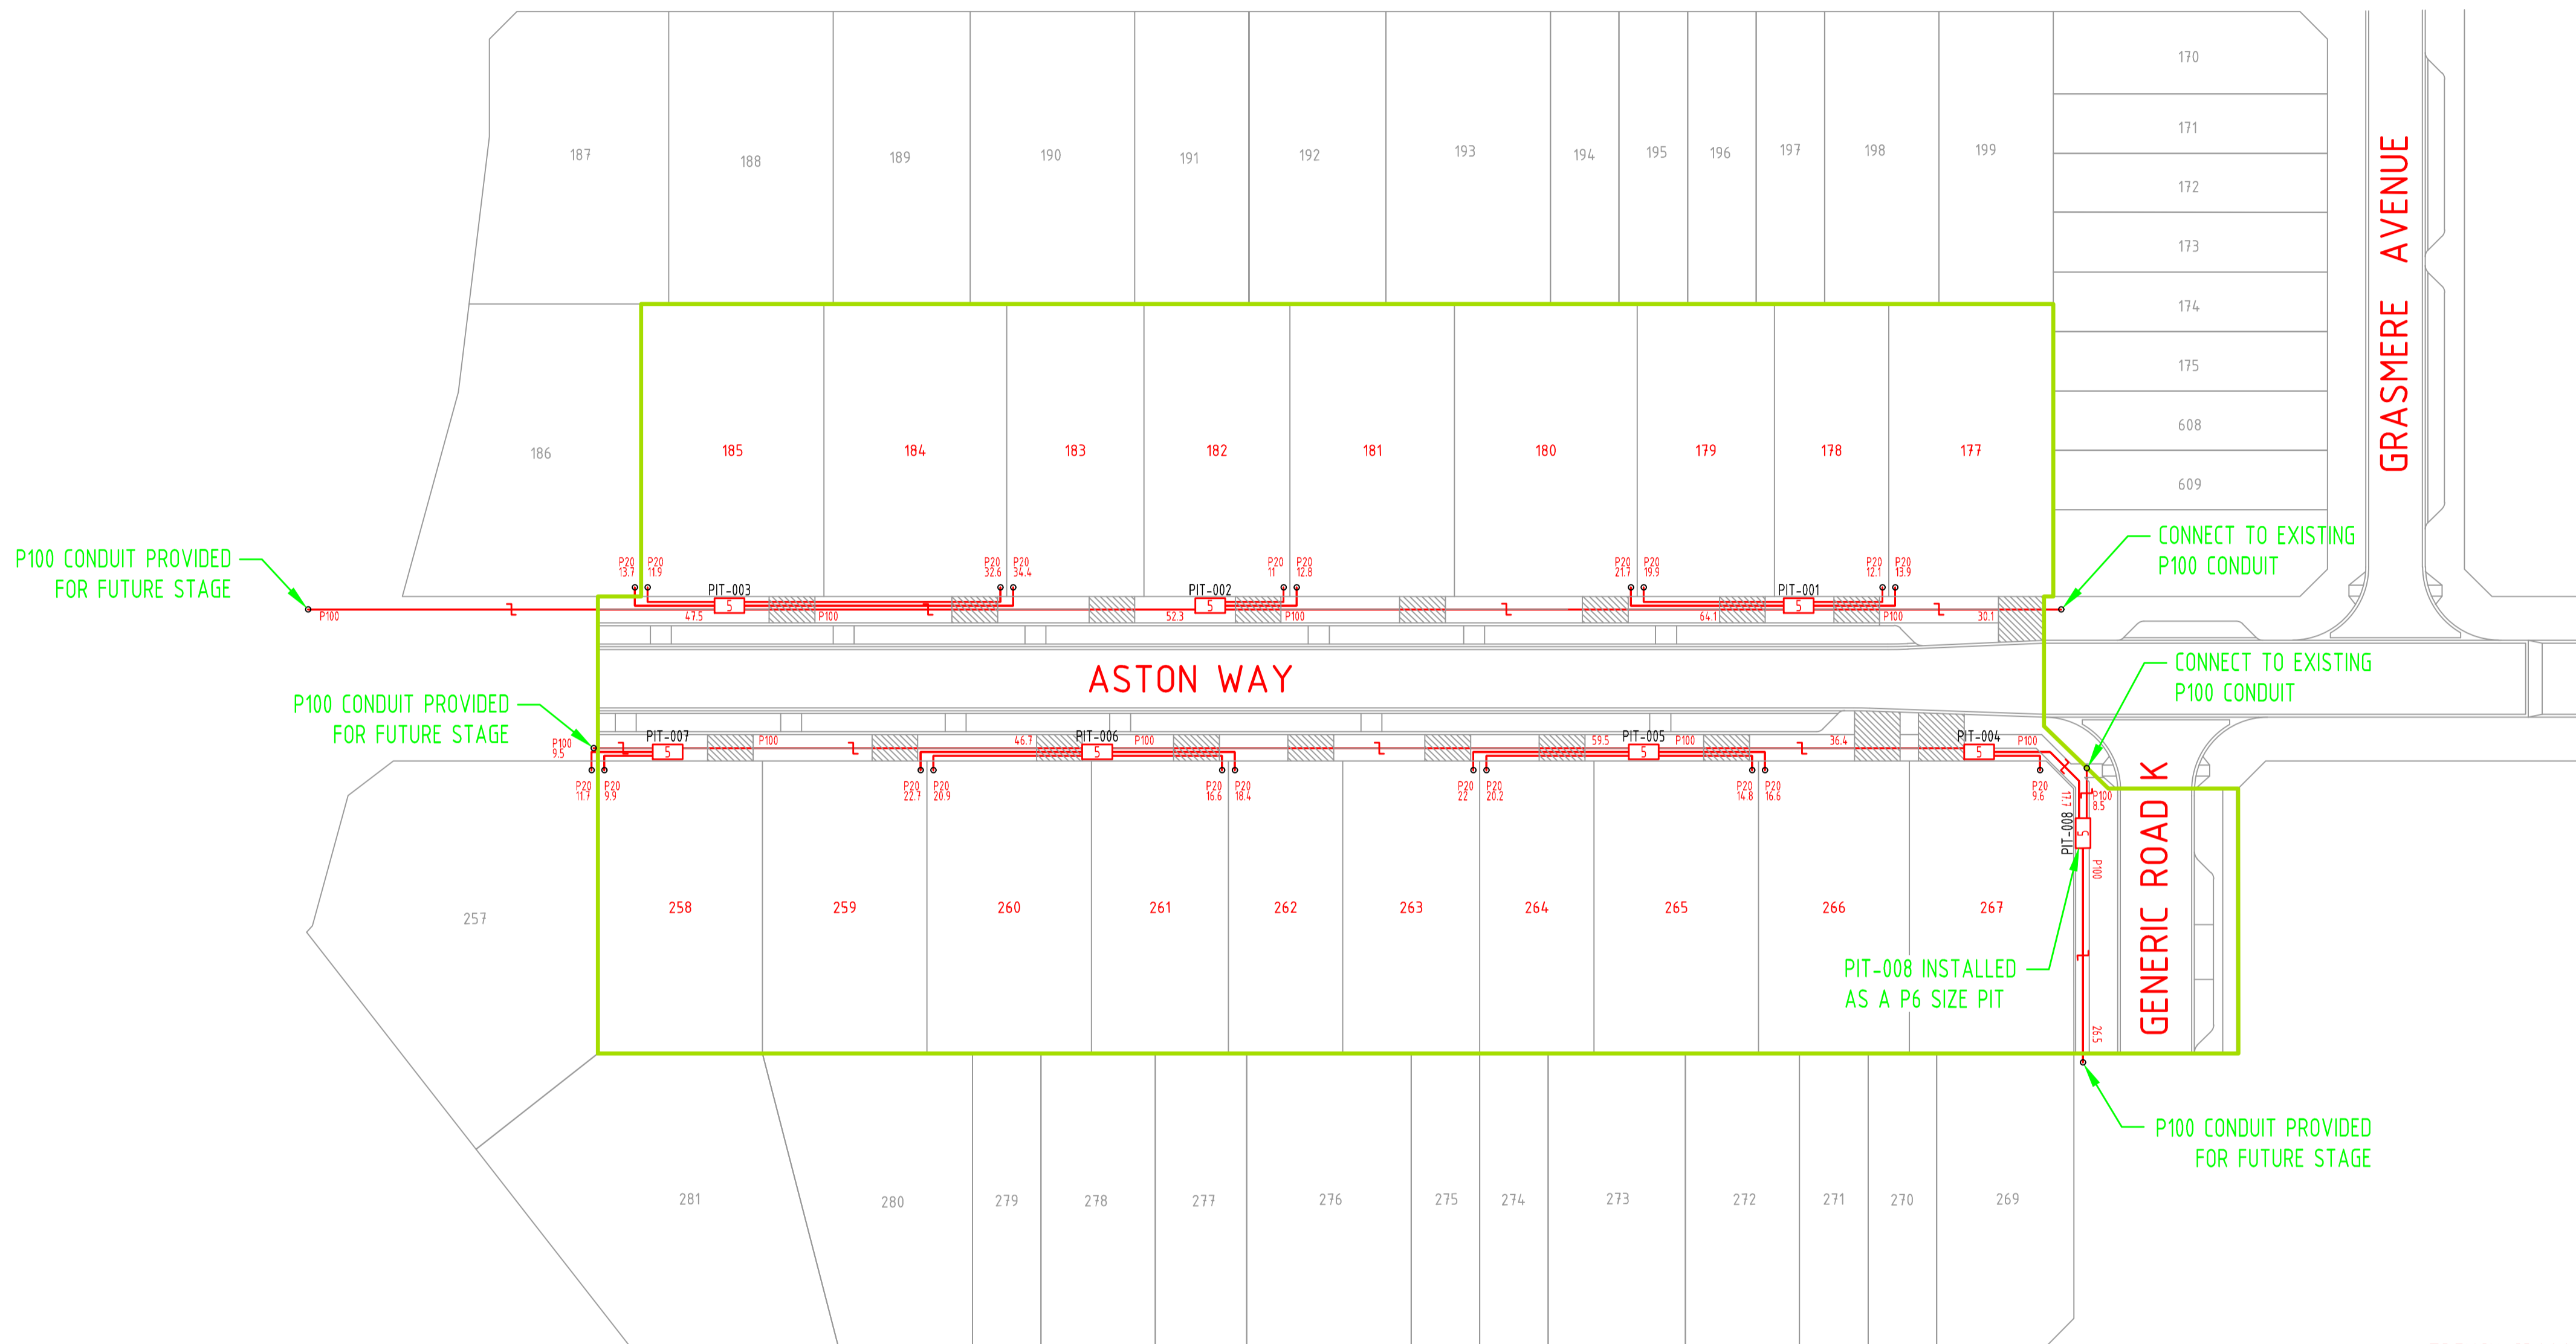

AS
CONSTRUCTED

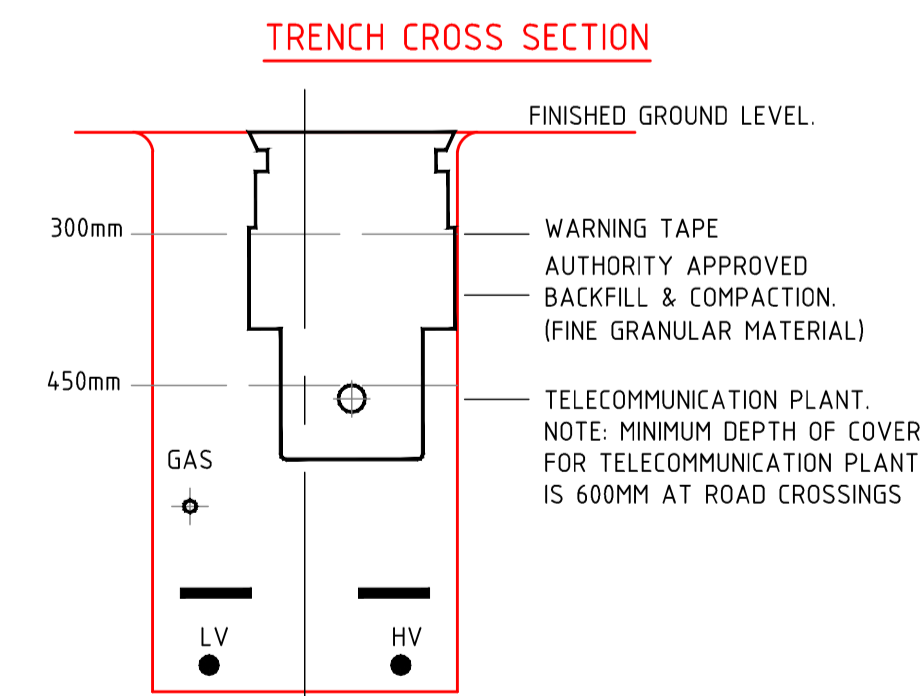

PIT DIMENSIONS TABLE - BY TYPE & SIZE.

PIT TYPE	Length	Width	Depth
P2 Pit	655mm	290mm	575mm
P5 Pit	710mm	455mm	635mm
P8 Pit	1370mm	550mm	860mm
P9 Pit	2040mm	550mm	900mm

- STANDARD SEPARATIONS AND CONSTRUCTION NOTES:**
- PITS SHOULD BE INSTALLED AT LEAST 15.0m AWAY FROM EPR ZONES
 - PITS SHOULD BE INSTALLED 1000mm CLEAR FROM OTHER COMMS PITS
 - CONDUITS SHOULD BE INSTALLED 300mm CLEAR FROM HV CABLES
 - CONDUITS SHOULD BE INSTALLED 150mm CLEAR FROM GAS PIPES 110mm OR LESS.
 - CONDUITS SHOULD BE INSTALLED 100mm CLEAR FROM ALL OTHER SERVICES
 - HORIZONTAL SEPARATION TO OTHER SERVICES INSIDE PROPERTY IS 150mm
 - DEPTH OF COVER FOR COMMS CONDUITS:
ROAD CROSSINGS - 600mm
VERGE - 450mm
SERVICE DROP CONDUIT - 300mm

ATTENTION
CONSTRUCTORS DO NOT
change or alter job
specifications unless first
checking with designer

REV	DATE	DRAFTER	DESCRIPTION	APPROVED
0	07.06.2017	J. BALINT	AS BUILT	A. FLETT
B	16.09.2016	N. MILLS	ISSUED FOR REVIEW	A. FLETT
A	21.07.2016	A. CADZOW	ISSUED FOR NBN REVIEW	A. FLETT

NBNCO APPROVAL RECORD:


SIGNATURE	DATE
<input type="checkbox"/> DD	_____
<input type="checkbox"/> WD	_____
<input type="checkbox"/> AB	_____

QUALITY RECORD :

NBNCO DISCLAIMER :

THIS DOCUMENT HAS BEEN PREPARED SOLELY FOR THE USE OF NBNCO LIMITED (ABN 86 136 533 741) FOR USE IN MAINTAINING NBNCO FACILITIES. IT HAS NOT BEEN CREATED FOR ANY OTHER USE. IT SHOULD NOT BE SCALED TO LOCATE NBNCO ASSETS. NO WARRANTY IS GIVEN THAT THE INFORMATION IS ACCURATE OR COMPLETE.

CONTRACTOR LOGO

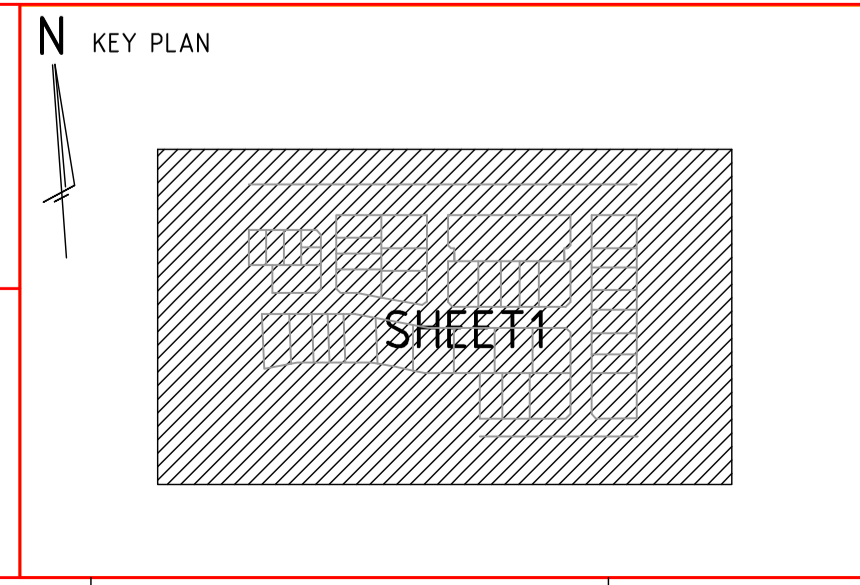

DRAWING TITLE:
ASTON HILLS
PAECH ROAD
MOUNT BARKER, SA, 5251
STAGE 7

STATE: SA	REGION: MT BARKER	
FSA: _____	FSAM: _____	FDA: _____
PROJECT No: 16-1284		
CADREF No: 16-1284-NBN-001-002		
SCALE: 1:500	SHEET No. 2 OF 2	REV. 0