

**PIT DIMENSIONS TABLE - BY TYPE & SIZE.**

PIT TYPE	Length	Width	Depth
P2 Pit	655mm	290mm	575mm
P5 Pit	710mm	455mm	635mm
P8 Pit	1370mm	550mm	860mm
P9 Pit	2040mm	550mm	900mm

- STANDARD SEPARATIONS AND CONSTRUCTION NOTES:**
- PITS SHOULD BE INSTALLED AT LEAST 15.0m AWAY FROM EPR ZONES
  - PITS SHOULD BE INSTALLED 1000mm CLEAR FROM OTHER COMMS PITS
  - CONDUITS SHOULD BE INSTALLED 300mm CLEAR FROM HV CABLES
  - CONDUITS SHOULD BE INSTALLED 150mm CLEAR FROM GAS PIPES 110mm OR LESS.
  - CONDUITS SHOULD BE INSTALLED 100mm CLEAR FROM ALL OTHER SERVICES
  - HORIZONTAL SEPARATION TO OTHER SERVICES INSIDE PROPERTY IS 150mm
  - DEPTH OF COVER FOR COMMS CONDUITS:  
 ROAD CROSSINGS - 600mm  
 VERGE - 450mm  
 SERVICE DROP CONDUIT - 300mm

THE INFORMATION IN THIS DRAWING HAS BEEN PROVIDED BY THE PROJECT PIT AND PIPE INSTALLATION CONTRACTORS. GREENHILL ENGINEERS DOES NOT GUARANTEE THAT THE DETAIL OR EXTENT OF INFORMATION SHOWN IS ACCURATE OR COMPLETE. GREENHILL ENGINEERS, CONSULTANTS, SERVANTS OR AGENTS SHALL NOT BE LIABLE FOR ANY LOSS OR DAMAGE CAUSED OR OCCASIONED BY THE USE OF THIS INFORMATION.

**Development Information**

Development Name:	BLEFARI	Developer Company:	LANSEY COMMUNITIES
Development Address:	MOUNT BARKER		
Authorised Rep:	ANTHONY ANDOLFATTO		
Phone:	0418824727		
E-Mail:	aandolfatto@lanser.com.au		
CRM ID:	AYCA-421IU5	Stage Number:	STAGE 1

**BILL OF MATERIAL**

NO OF LOTS: 89

PITS		DUCTS		MTRS
SIZE	QTY	SIZE	QTY	
2	2	P100	34	1505
5	20	P50	4	125.9
8	6	P23	86	14,318
9	0			

TOTAL NUMBER OF PITS: 28  
 TOTAL NUMBER OF CONDUITS: 124  
 TOTAL LENGTH OF CONDUITS: 3062.7

**AS  
CONSTRUCTED**

**\*\*ATTENTION\*\***  
 CONSTRUCTORS DO NOT  
 change or alter job specifications  
 unless first checking with  
 designer.

REV	DATE	DRAFTER	DESCRIPTION	APPROVED
5	29.09.17	K. DICKSON-ABBOTT	REVISED AS CONSTRUCTED	A. FLETT
4	12.09.17	K. DICKSON-ABBOTT	REVISED AS CONSTRUCTED	A. FLETT
3	04.08.2017	A. CADZOW	AS CONSTRUCTED	A. FLETT
2	23.05.2017	N. MILLS	FOR CONSTRUCTION	A. FLETT
1	11.05.2017	N. MILLS	FOR CONSTRUCTION	A. FLETT
0	03.03.2017	A. CADZOW	FOR CONSTRUCTION	A. FLETT
C	22.02.2017	N. MILLS	REISSUED FOR APPROVAL	A. FLETT
B	23.01.2017	N. MILLS	REISSUED FOR APPROVAL	A. FLETT

**NBNCO APPROVAL RECORD:**


SIGNATURE	DATE
<input type="checkbox"/> DD	_____
<input type="checkbox"/> WD	_____
<input type="checkbox"/> AB	_____

**QUALITY RECORD:**

NBNCO DISCLAIMER  
 THIS DOCUMENT HAS BEEN PREPARED SOLELY FOR THE USE OF NBNCO LIMITED (ABN 86 136 533 741) FOR USE IN MAINTAINING NBNCO FACILITIES. IT HAS NOT BEEN CREATED FOR ANY OTHER USE. IT SHOULD NOT BE SCALED TO LOCATE NBNCO ASSETS. NO WARRANTY IS GIVEN THAT THE INFORMATION IS ACCURATE OR COMPLETE.

**NBNCo Limited**

**GREENHILL**  
 Level 1, 64 Hindmarsh Square  
 CONTRACTOR LOC  
 F: 08 8215 0018  
 ABN 59 061 222 964

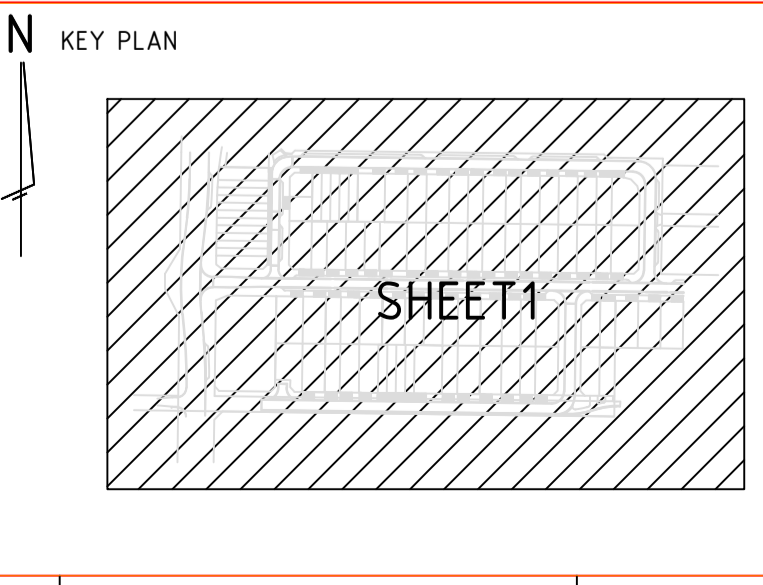

**DRAWING TITLE:**  
 BLEFARI  
 SIMS ROAD  
 MOUNT BARKER, SA, 5251  
 STAGE 1

STATE:	SA	REGION:	MT BARKER
FSA:		FSAM:	
FDA:			
PROJECT No:	16-1361		
CADREF No:	16-1361-NBN-001-002		
SCALE	SHEET No.	OF	REV.
1:500	1	2	5